
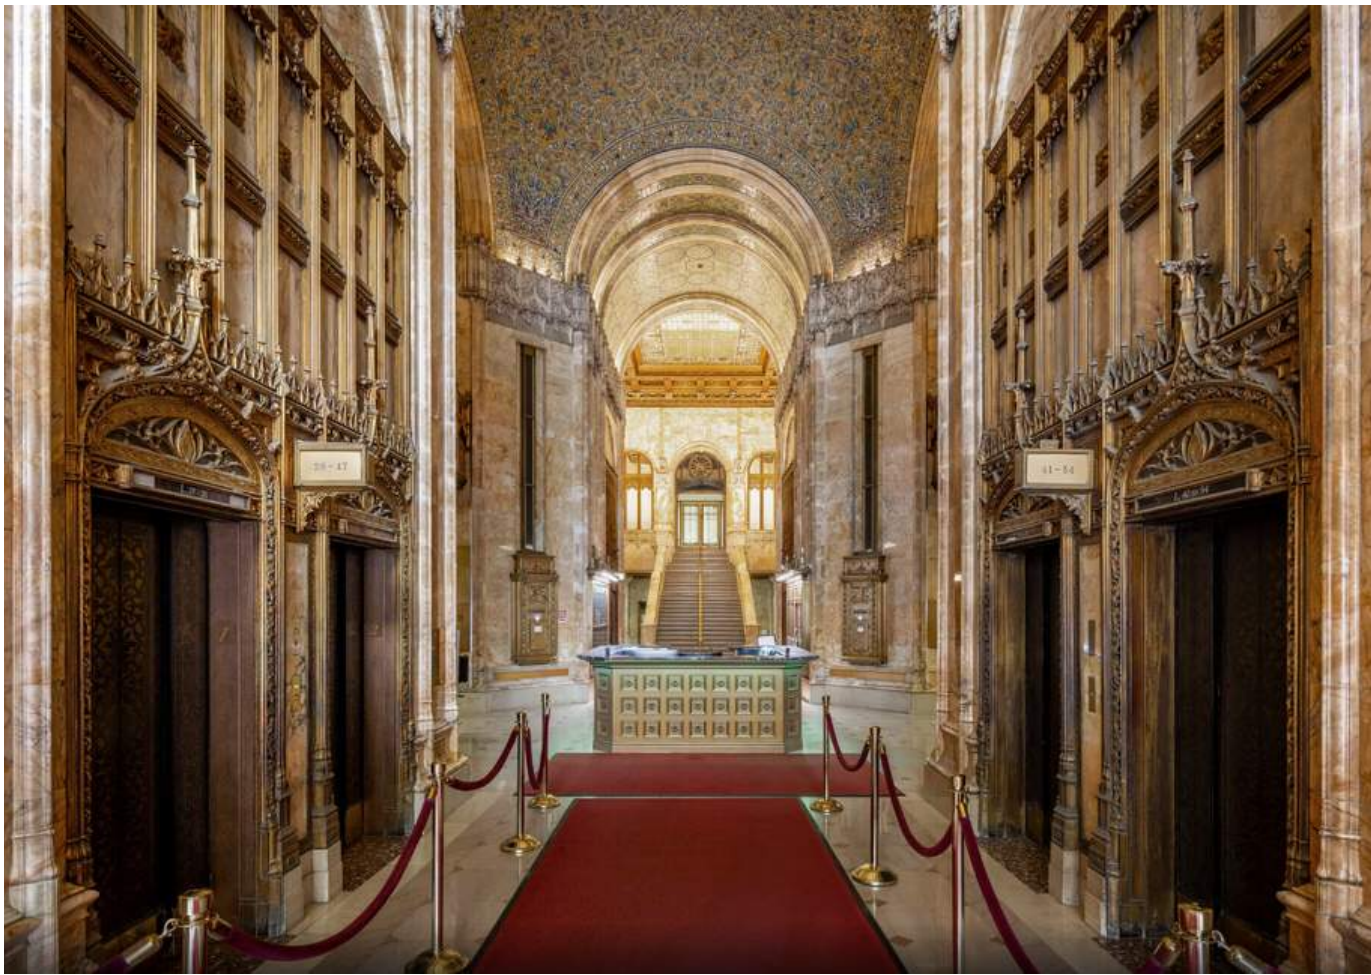
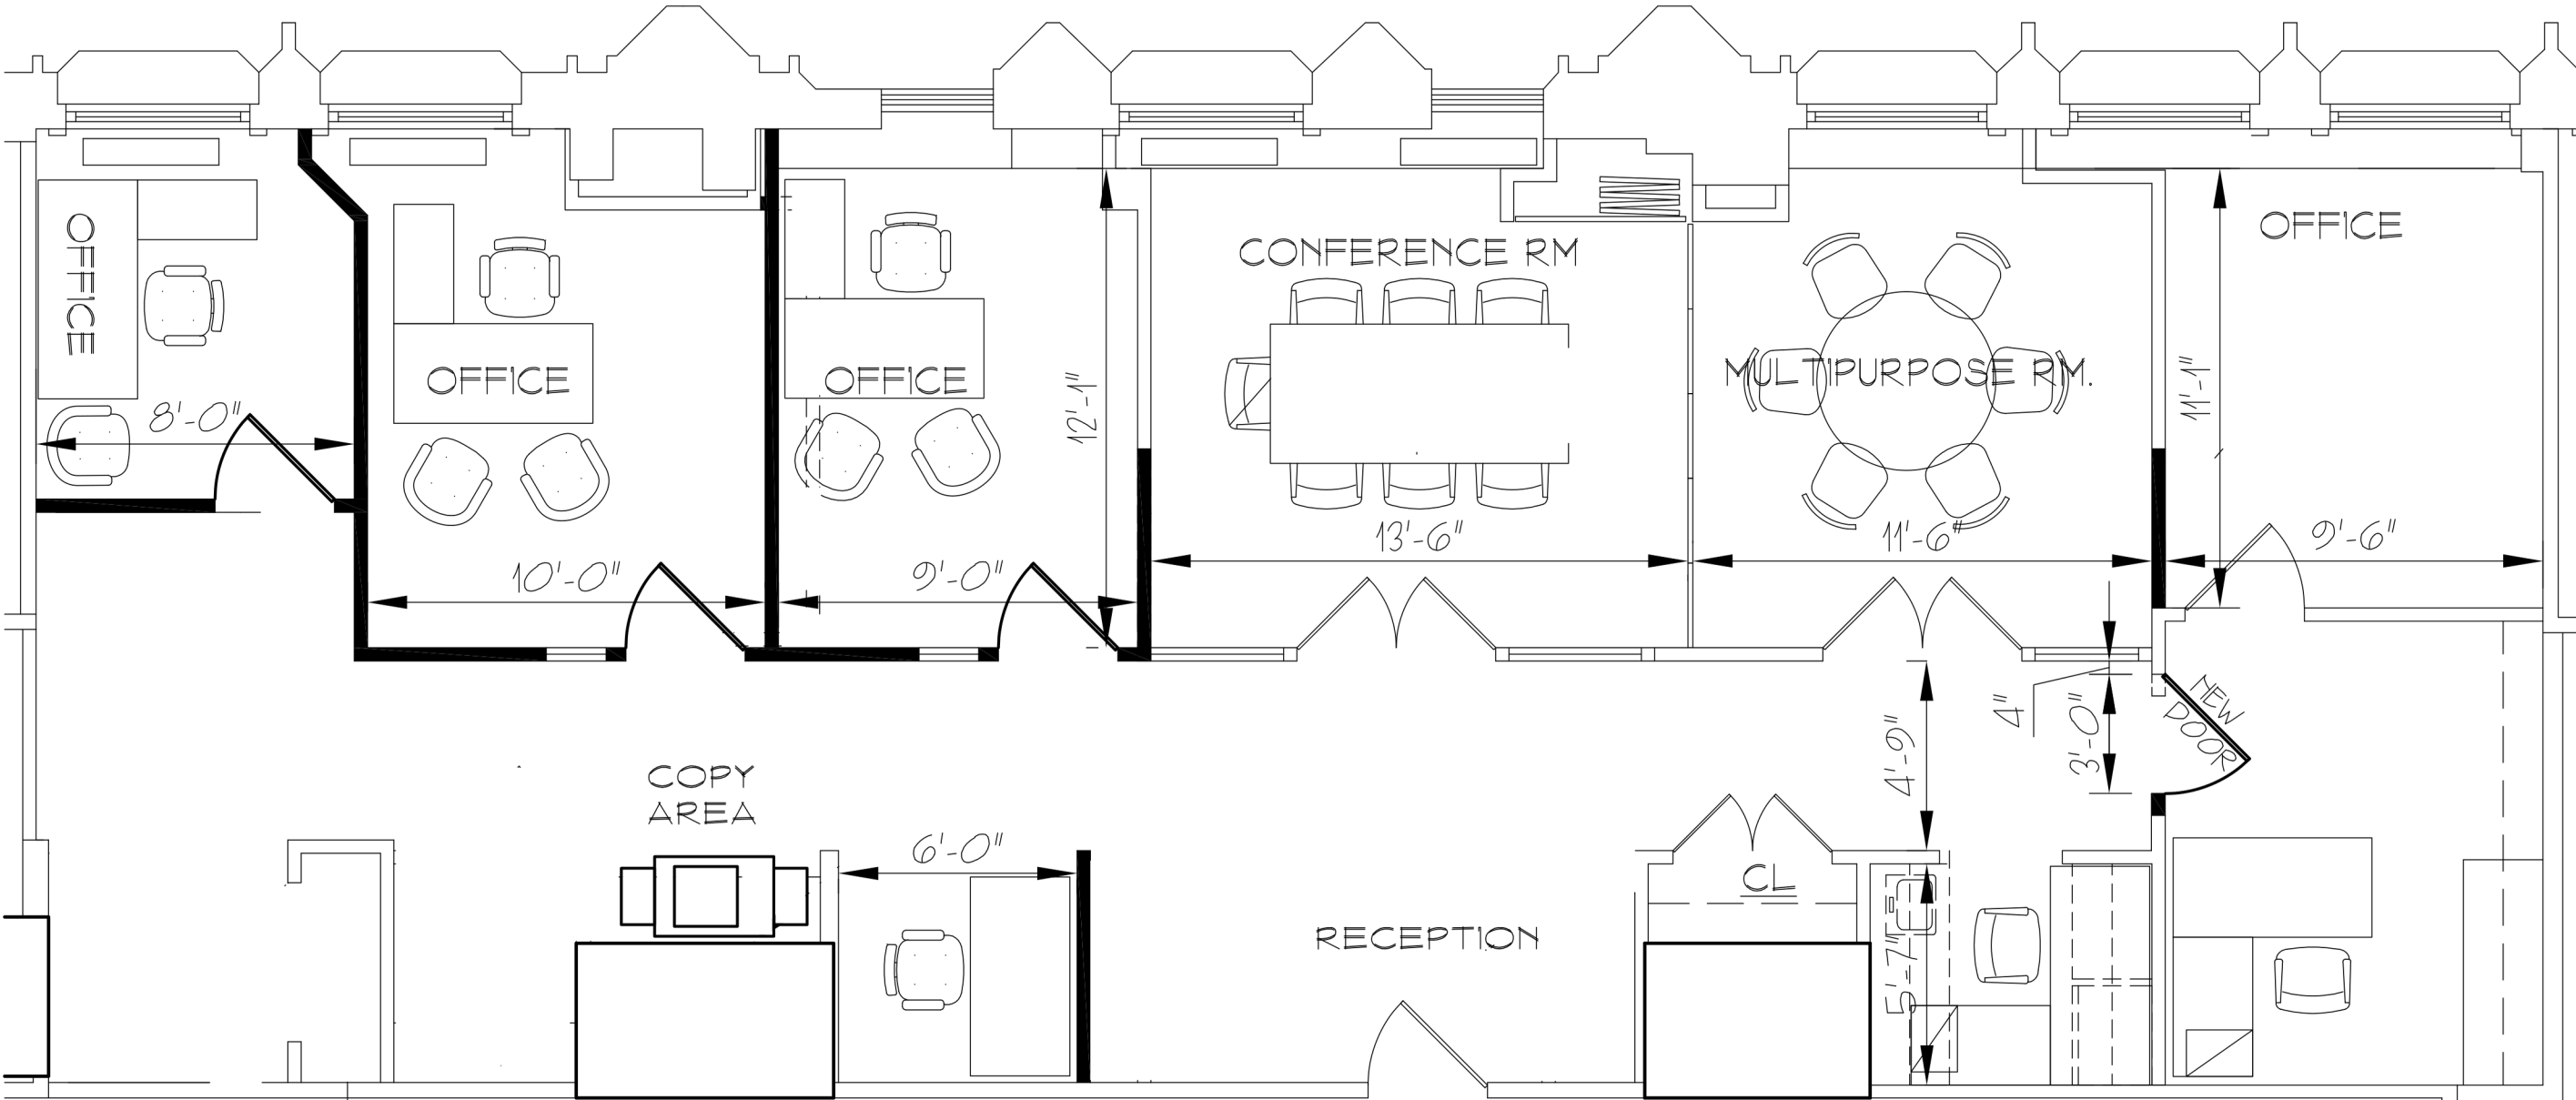


**233 BROADWAY**  
**22ND FLOOR**

**SUITE 2205**

**2,364 RSF**

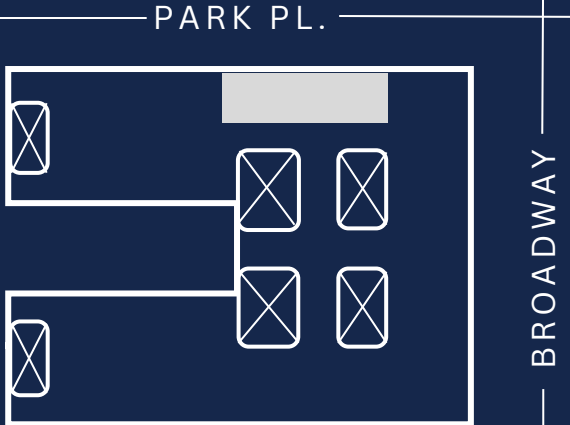

212-284-3756

[www.cammebys.com](http://www.cammebys.com)

**Cammeby's**